


NOTE:
FOR BUILDING AREA BREAKDOWN
AND AREA CALCULATIONS SUMMARY,
SEE APPRAISAL PAGE 57.
[HTTP://WWW.CITYOFHENDERSONVILLE.ORG/MODULES/SHOWDOCUMENT.ASPX?DOCUMENTID=3046](http://www.cityofhendersonville.org/modules/showdocument.aspx?documentid=3046)

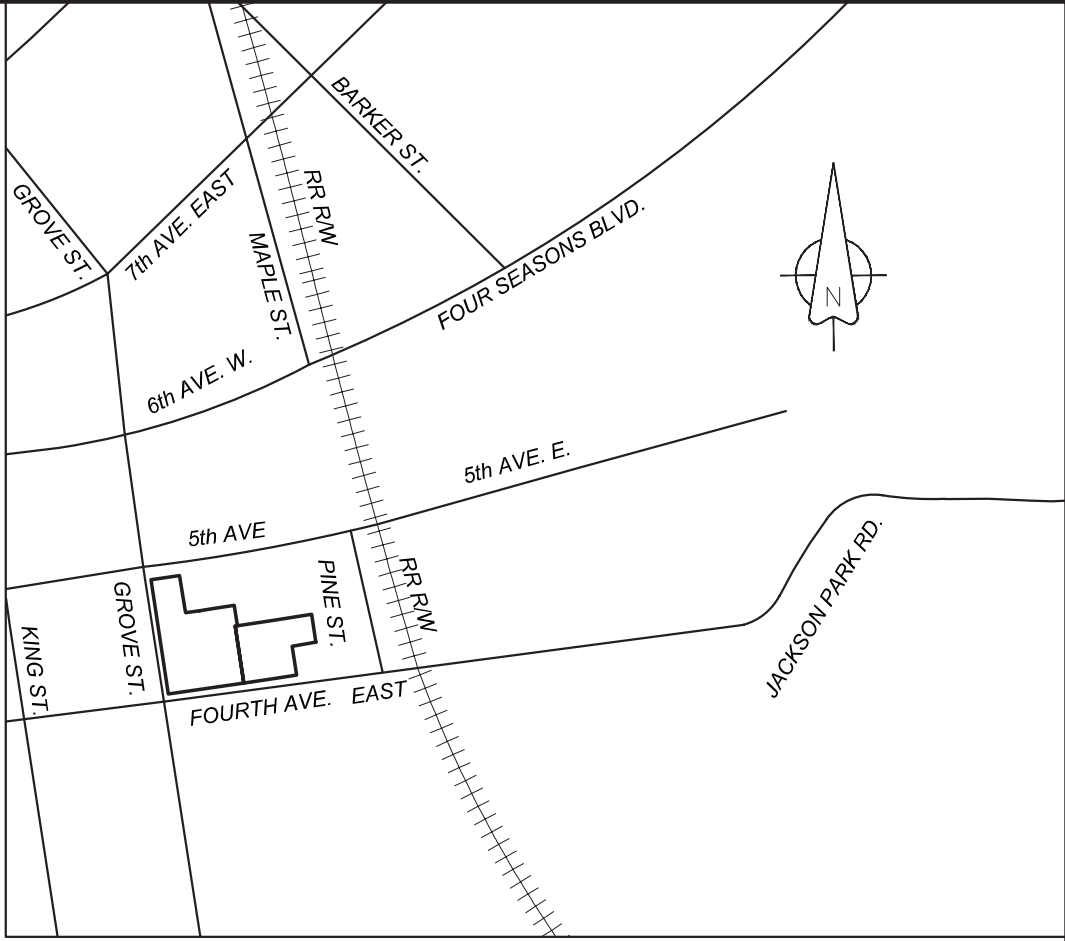

Vicinity Map
NOT TO SCALE


LEGEND

MASONRY WALL	
POSTS	
BEAMS	
DOORS	
CENTER LINE	
WINDOWS	
FENCE LINE	
PARTITIONS	
SKY LIGHTS	

NOTE:
NOT A SURVEY



FLOOR PLAN

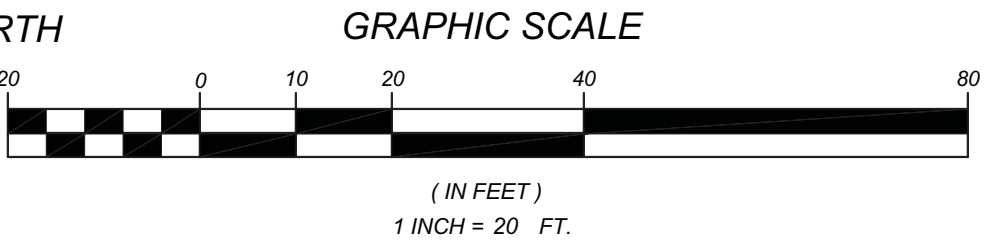

CITY OF HENDERSONVILLE, N.C.
"The City of Four Seasons"
Barbara Volk
Mayor


PROJECT: **HOSIERY MILL EXISTING CONDITIONS**

Engineering Department
Brent G. Detwiler, P.E.
Director


Produced by: Staff Checked by: BD

#	DATE	NOTES
1	5-26-10	AREA CALCULATIONS SUMMARY


Date: 05-11-10 MMP PAGE 1 OF 2

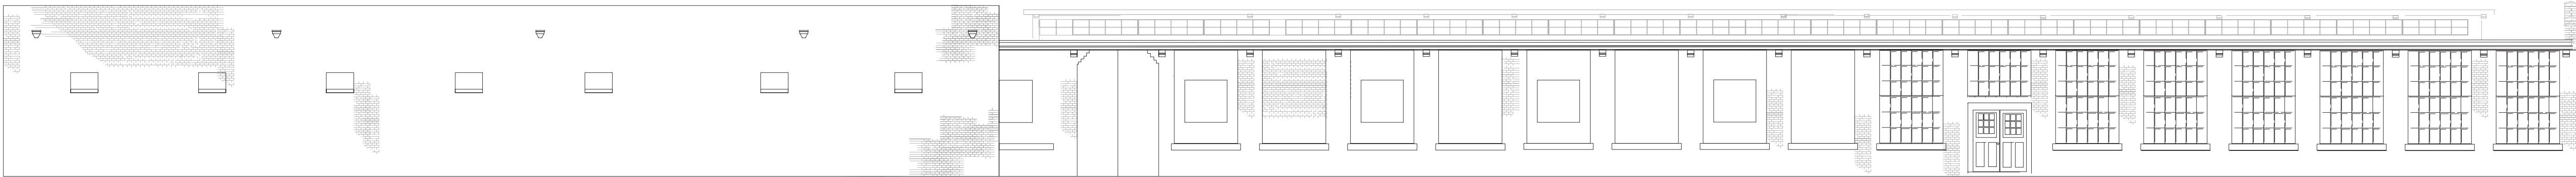


WEST ELEVATION

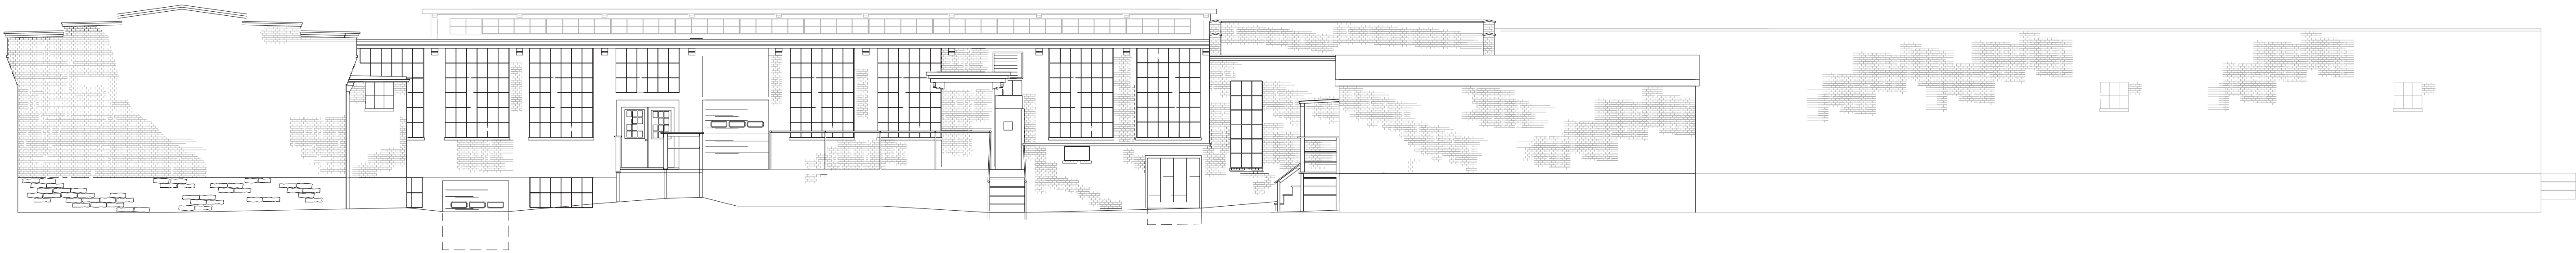

EAST ELEVATION

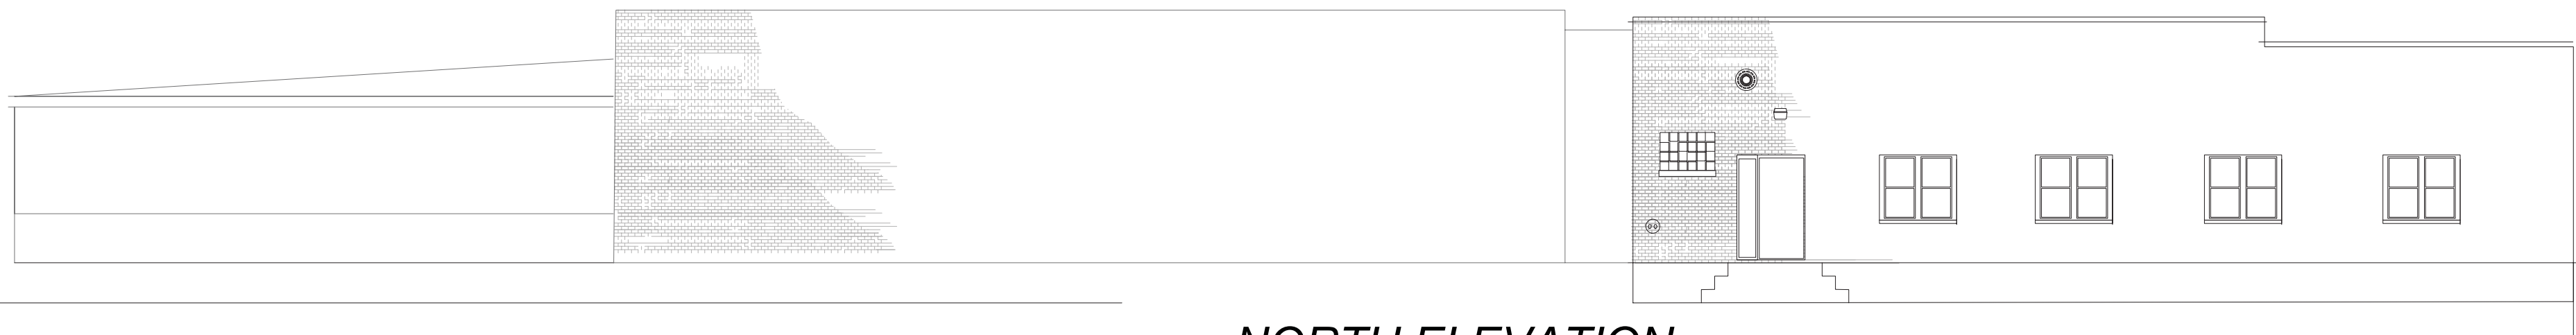


NORTH ELEVATION

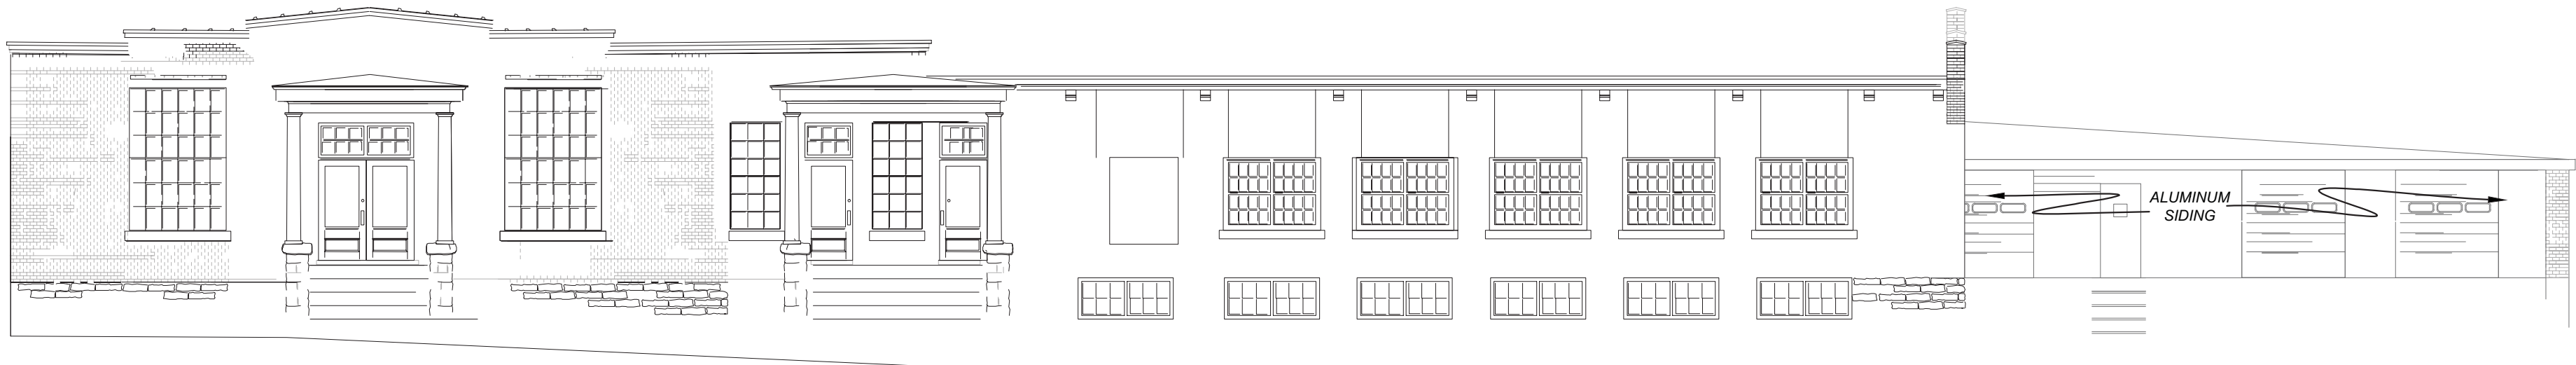

SOUTH ELEVATION

ELEVATIONS

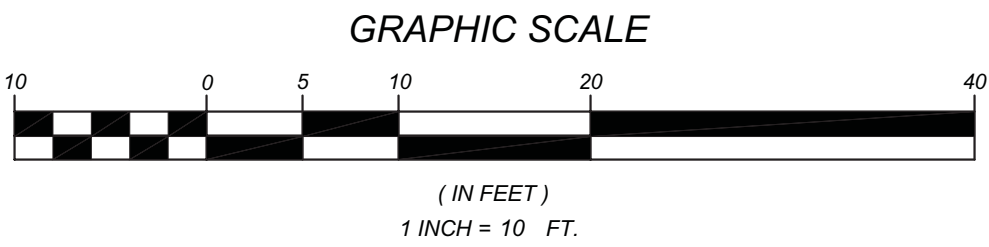

CITY OF HENDERSONVILLE, N.C.
"The City of Four Seasons"
Barbara Volk
Mayor

PROJECT: **HOSIERY MILL**
EXISTING CONDITIONS

Engineering Department
Brent G. Detwiler, P.E.
Director

Produced by: Staff
Checked by: BD

REVISIONS

#	DATE	NOTES

Date: 05-11-10 MMP PAGE 2 OF 2